

**ENGINEER'S CERTIFICATION**

I, \_\_\_\_\_, hereby certify that:

- The information contained in this drawing / document is in compliance with approved drawings and design.
- The new water and sewerage works defined by this drawing have been designed and constructed in accordance with the SEQ Code.
- This represents an accurate record of as-constructed works.
- I accept responsibility for the information contained in this drawing / document.


RPED (signature) RPED No. \_\_\_\_\_ Date: \_\_\_\_\_

**REGISTERED SURVEYOR'S CERTIFICATION**

I, LANDPARTNERS PTY LTD, hereby certify that the vertical and horizontal locations and dimensions shown on this plan are a true and correct record and were located by survey.

*[Signature]*  
Registered Surveyor (sig) Reg. Surveyor No. 4118 Date: 28/02/2023

**COORDINATE DATUM NOTE:**  
HORIZONTAL COORDINATES(E,N) SUPPLIED ARE MAPPING GRID OF AUSTRALIA(MGA), ZONE 56 BASED ON THE UNIVERSAL TRANSVERSE MERCATOR PROJECTION AND THE GEOCENTRIC DATUM OF AUSTRALIA 1994.

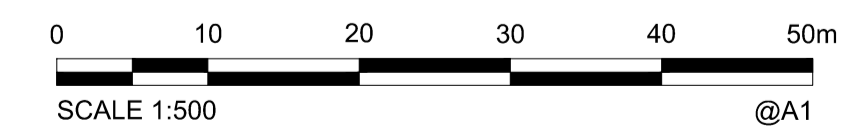

**AS CONSTRUCTED**

<b>A1</b>	1	28/02/23	INITIAL ISSUE	VO	LS	LS
	INDEX	DATE	REVISIONS	DRAWN	CHECKED	PASSED

DRAWN	VO	28/02/2023
CHECKED	LS	28/02/2023
PASSED	LS	28/02/2023
INITIALS	DATE	



**Unitywater**  
2022021447S1  
The Junction, Narangba  
Stage 1  
As-Constructed Water

SHEET 1 OF 1 SHEETS	SCALE 1:500
REVISION DATE 28/02/2023	REVISION 1
DISCIPLINE CODE C	
DRAWING NO. U-2022-4342	